

FRANK S	HIRLEY
ARCHIT	ECTS
40 Pearl Street	t: 617.547.3355
Cambridge MA 02139 www.frankshirleva	f: 617.547.2385

PROJECT

Addition & Alterations to:

The MAGDANZ RESIDENCE

172 Brattle St. Cambridge, MA 02138

Date	Description
21 SEP 22	CHC SUBMISSION
	~

ISSUES / REVISIONS

NOT FOR CONSTRUCTION

© FRANK SHIRLEY ARCHITECTS, 2022. All rights reserved.

This drawing cannot be reproduced without permission.

DRAWING TITLE


Site Plan

0 2 4 8 16 FT
DATE

September 21, 2022

SHEET NUMBER

SITE PLAN

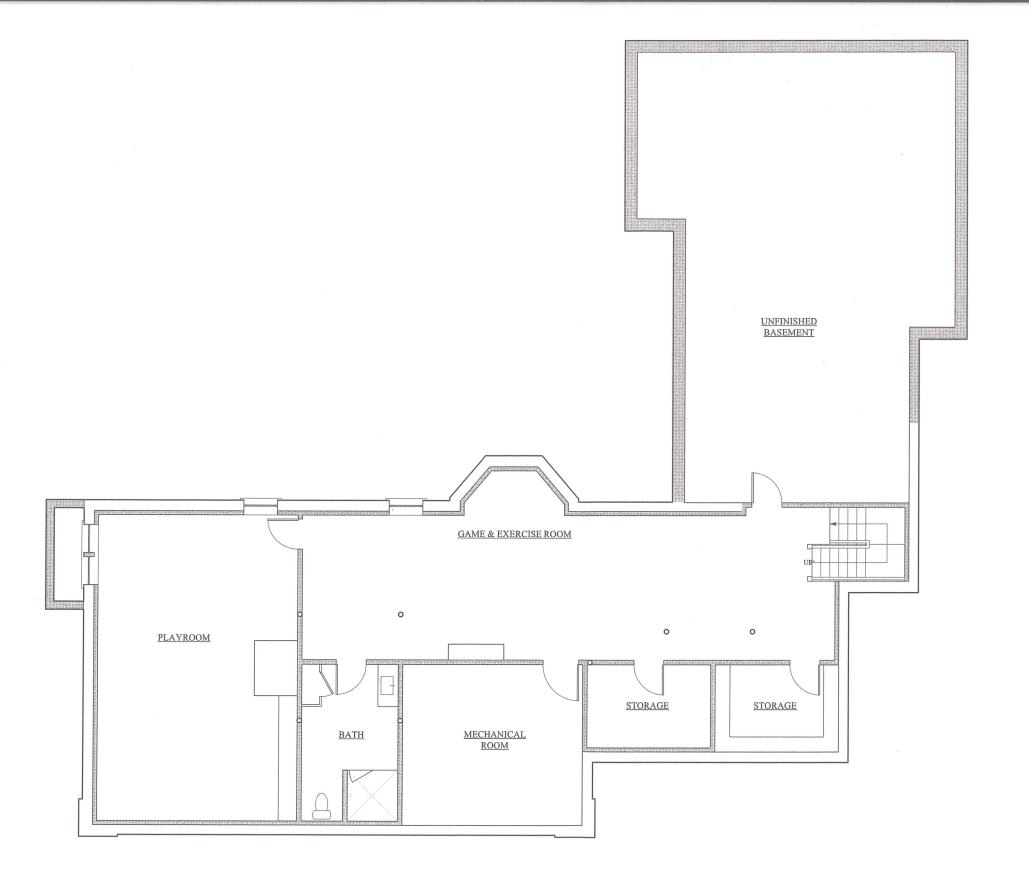



40 Pearl Street Cambridge MA 02139

t: 617.547.3355 f: 617.547.2385

www.frankshirleyarchitects.com

ARCHITECTS

PROJECT

Addition & Alterations to:

The MAGDANZ RESIDENCE

172 Brattle St. Cambridge, MA 02138

ISSUES / REVISIONS

Date Description 13 SEP 22 CHC SUBMISSION

NOT FOR CONSTRUCTION

© FRANK SHIRLEY ARCHITECTS, 2022. All rights reserved. This drawing cannot be reproduced without permission.

Basement Floor Plan - Final

8 FT 1/8" = 1'-0"

DATE

September 13, 2022


SHEET NUMBER

A-1

BASEMENT FLOOR PLAN - FINAL

SCALE: 1/8" = 1'-0"

LEGEND NEW STUD WALL EXISTING WALL TO REMAIN

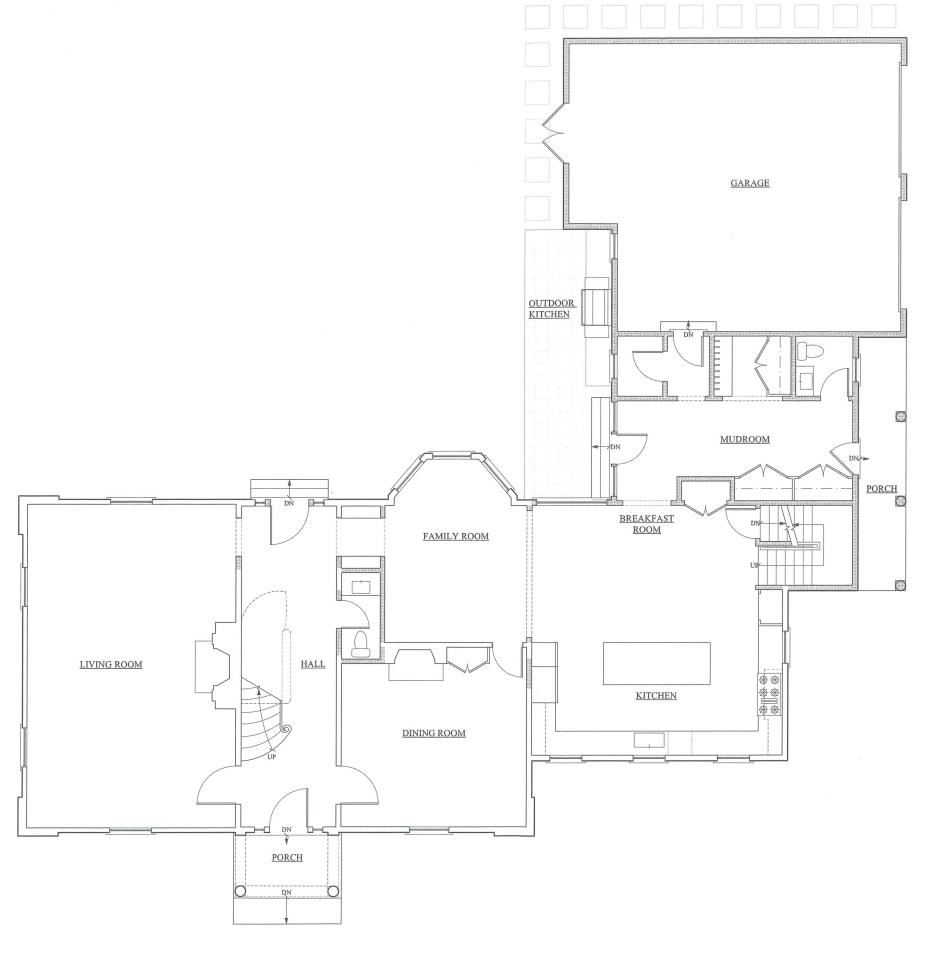



ARCHITECTS

t: 617.547.3355 40 Pearl Street Cambridge MA 02139 f: 617.547.2385

www.frankshirleyarchitects.com

PROJECT

Addition & Alterations to:

The MAGDANZ RESIDENCE

172 Brattle St. Cambridge, MA 02138

ISSUES / REVISIONS

Date Description 13 SEP 22 CHC SUBMISSION

NOT FOR CONSTRUCTION

© FRANK SHIRLEY ARCHITECTS, 2022. All rights reserved. This drawing cannot be reproduced without permission.

DRAWING TITLE

First Floor Plan - Final

8 FT 1/8" = 1'-0"

September 13, 2022

SHEET NUMBER


A-2

FIRST FLOOR PLAN - FINAL SCALE: 1/8" = 1'-0"

LEGEND

EXISTING WALL TO REMAIN

NEW STUD WALL

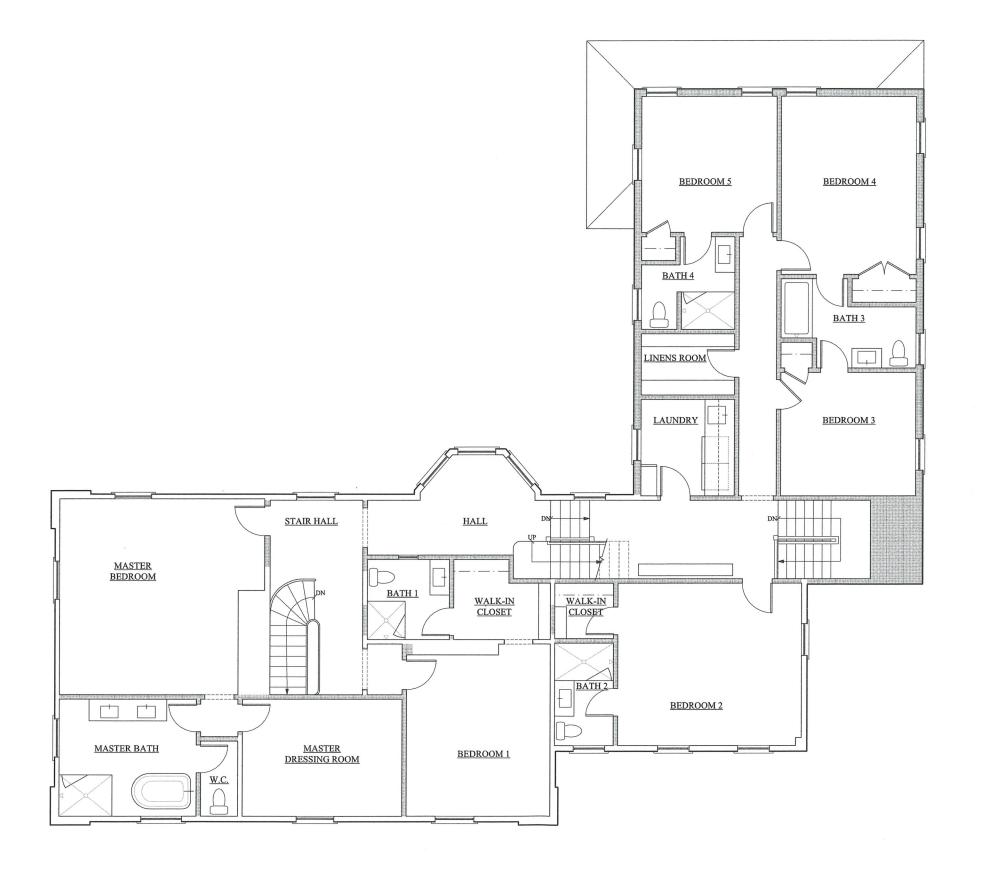



FRANK SHIRLEY ARCHITECTS

40 Pearl Street t: 617.547.3355 f: 617.547.2385 Cambridge MA 02139

www.frankshirleyarchitects.com

PROJECT

Addition & Alterations to:

The MAGDANZ RESIDENCE

172 Brattle St. Cambridge, MA 02138

ISSUES / REVISIONS

Date Description 13 SEP 22 CHC SUBMISSION

NOT FOR CONSTRUCTION

© FRANK SHIRLEY ARCHITECTS, 2022. All rights reserved. This drawing cannot be reproduced without permission.

DRAWING TITLE

Second Floor Plan - Final

1/8" = 1'-0"

September 13, 2022

SHEET NUMBER


A-3

SECOND FLOOR PLAN - FINAL SCALE: 1/8" = 1'-0"

LEGEND

EXISTING WALL TO REMAIN

NEW STUD WALL

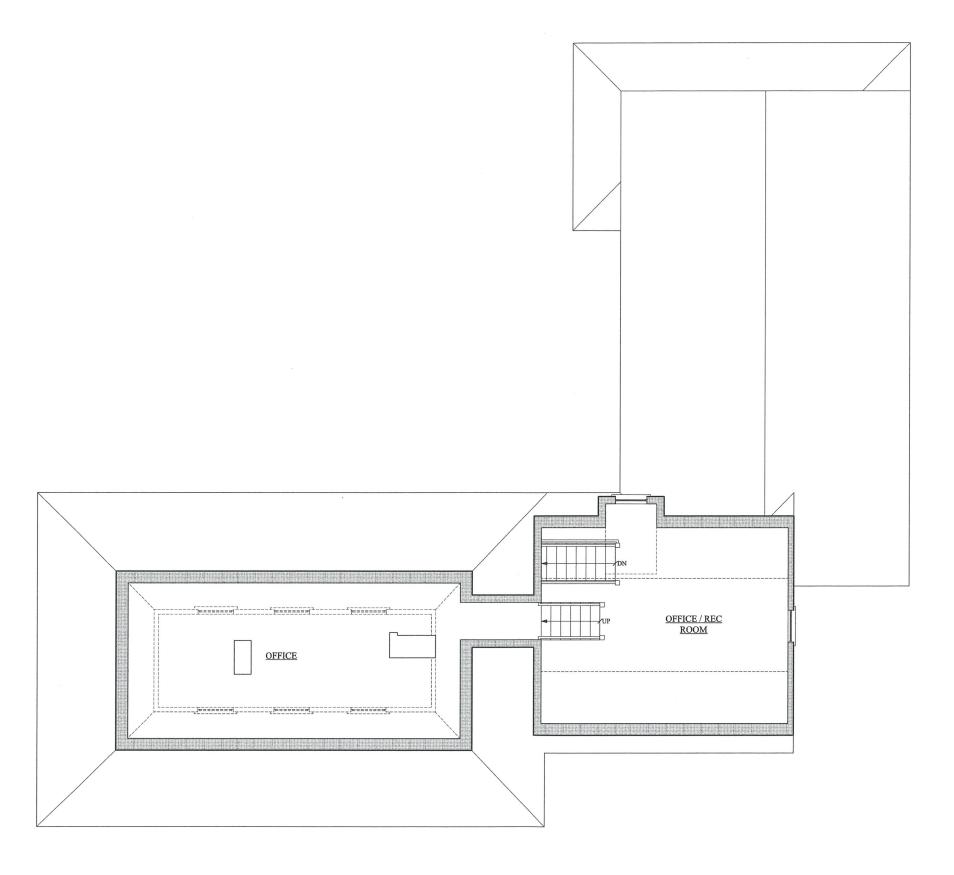

ARCHITEC	
	T S
	7.547.3355 7.547.2385 ts.com
PROJECT Addition & Alterations t	o:
T h e M A G D A N Z R E S I D E N C E	
172 Brattle St. Cambridge, MA 02138	
Date Description 13 SEP 22 CHC SUBMISSION	
NOT FOR CONSTRUC	TION
© EDANIK CHIRDLEY ADCHITECTE 2022 All de	
© FRANK SHIRLEY ARCHITECTS, 2022. All rig This drawing cannot be reproduced without pe	
DRAWING TITLE Third Floor	rmission.

September 13, 2022

A-4

SHEET NUMBER

LEGEND NEW STUD WALL EXISTING WALL TO REMAIN

THIRD FLOOR PLAN - FINAL SCALE: 1/8" = 1'-0"





FRANK SHIRLEY ARCHITECTS 40 Pearl Street t: 617.547.3355 Cambridge MA 02139 f: 617.547.2385 www.frankshirleyarchitects.com PROJECT Addition & Alterations to: The MAGDANZ RESIDENCE 172 Brattle St. Cambridge, MA 02138 ISSUES / REVISIONS Date Description
21 SEP 22 CHC SUBMISSION NOT FOR CONSTRUCTION © FRANK SHIRLEY ARCHITECTS, 2022. All rights reserved. This drawing cannot be reproduced without permission. DRAWING TITLE North & West Elevations - Final 8 FT 1/8" = 1'-0" September 21, 2022

SHEET NUMBER

A-5

WEST ELEVATION - FINAL
SCALE: 1/8" = 1'-0"



FRANK SHIRLEY
ARCHITECTS

40 Pearl Street t: 617.547.3355 Cambridge MA 02139 f: 617.547.2385

www.frankshirleyarchitects.com

PROIF

Addition & Alterations to:

The MAGDANZ RESIDENCE

172 Brattle St. Cambridge, MA 02138

ISSUES / REVISIONS

Date Description
21 SEP 22 CHC SUBMISSION

© FRANK SHIRLEY ARCHITECTS, 2022. All rights reserved.
This drawing cannot be reproduced without permission.

NOT FOR CONSTRUCTION

DRAWING TITLE

South Elevation and Section - Final

0 1 2

8 FT 1/8" = 1'-0"

D/

September 21, 2022

SHEET NUMBER

A-6

SOUTH ELEVATION - FINAL
SCALE: \(\frac{1}{8}\)" = \(\frac{1}{-}0\)"



1 EAST ELEVA SCALE: 1/8" = 1'-0" FRANK SHIRLEY ARCHITECTS t: 617.547.3355 40 Pearl Street Cambridge MA 02139 www.frankshirleyarchitects.com PROJECT Addition & Alterations to: The MAGDANZ RESIDENCE 172 Brattle St. Cambridge, MA 02138 ISSUES / REVISIONS Date Description
21 SEP 22 CHC SUBMISSION NOT FOR CONSTRUCTION © FRANK SHIRLEY ARCHITECTS, 2022. All rights reserved. This drawing cannot be reproduced without permission. DRAWING TITLE East Elevation - Final September 21, 2022

SHEET NUMBER

A-7



AS BUILT SOUTH ELEVATION

SCALE: 1/4" = 1'-0"

ARCHITECTS
40 Panel Street 5, 617 E47 22 E
40 Pearl Street t: 617.547.3355 Cambridge MA 02139 f: 617.547.2385
www.frankshirleyarchitects.com
PROJECT
Ale de la constant de
Alterations to:
The
MAGDANZ
RESIDENCE
172 Brattle St.
Cambridge, MA 02138
THESE EXISTING PLANS AND/OR PHOTOGRAPIS ARE A REPRESENTATION OF THE EXISTING CONDITIONS OF THE BULLDOM. THESE DAAWNGSPHOTOGRAPIS ARE FOR THE STREAM OF THE S
EXHAUSTIVE INVESTIGATION INTO ACTUAL HIDDEN CONDITIONS, THIS INFORMATION IS FOR COORDINATION OF THE WORK TO BE PREFORMED BY THE GENERAL CONTRACTOR. THE ACTUATE OF THE STATE O
THE GENERAL CONTRACTOR SHALL EXAMINE THESE CONDITIONS IN THE FIELD PRIOR TO CONSTRUCTION AND BECOME FAMILIAR WITH THE WORK. AFTER EXAMINATION OF THE EXISTING CONDITIONS THE GENERAL CONSTRUCTION STALL UNDER ALL CONDITIONS.
AND DIMENSIONS AND NOTIFY THE ARCHITECT OF ANY DISCREPANCIES BETWEEN THE EXISTING CONDITIONS AND THE NEW PROPOSED WORK. ALL WORK CONSTRUCTED BRIDE TO VOTE OF THE TOTAL PROPOSED WORK.
PLANS AND DIMENSIONS SHALL BE REPLACED BY THE GENERAL CONTRACTOR.
a a
ISSUES / REVISIONS
ISSUES / REVISIONS
Date Description 11 JUL 22 AS-BUILT RELEASE
11 JUL 22 AS-BUILT RELEASE
-
© FRANK SHIRI EV ABCHITECTS 2022 All sinhs consumal
© FRANK SHIRLEY ARCHITECTS, 2022. All rights reserved, This drawing cannot be reproduced without permission.
This drawing cannot be reproduced without permission.
This drawing cannot be reproduced without permission. DRAWING TITLE
This drawing cannot be reproduced without permission.
This drawing cannot be reproduced without permission. DRAWING TITLE As-Built South Elevation
This drawing cannot be reproduced without permission. DRAWING TITLE As-Built South Elevation SCALE
This drawing cannot be reproduced without permission. DRAWING TITLE As-Built South Elevation
This drawing cannot be reproduced without permission. DRAWING TITLE As-Built South Elevation SCALE 0 1 2 4 8 FT
This drawing cannot be reproduced without permission. DRAWING TITLE As-Built South Elevation SCALE 0 1 2 4 8 FT
This drawing cannot be reproduced without permission. DRAWING TITLE As-Built South Elevation SCALE 1/4" = 1'-0" DATE
This drawing cannot be reproduced without permission. DRAWING TITLE As-Built South Elevation SCALE 1/4" = 1'-0"
This drawing cannot be reproduced without permission. DRAWING TITLE As-Built South Elevation SCALE 1/4" = 1'-0" DATE
This drawing cannot be reproduced without permission. DRAWING TITLE As-Built South Elevation SCALE 0 1 2 4 8 FT 1/4" = 1'-0" DATE July 11, 2022



AS BUILT WEST ELEVATION

SCALE: 1/4" = 1'-0"

FRANK SHIRLEY
ARCHITECTS
-
40 Pearl Street t: 617.547.3355 Cambridge MA 02139 f: 617.547.2385
www.frankshirleyarchitects.com
·
PROJECT
Alterations to:
The
MAGDANZ
RESIDENCE
172 Brattle St.
Cambridge, MA 02138
THESE EXISTING PLANS AND/OR PHOTOGRAPHS ARE A REPRESENTATION OF THE EXISTING CONDITIONS OF THE BUILDING. THESE DEA/WINGOPHOTOGRAPHS ARE FOR EXISTING CONDITIONS OF THE BUILDING. THESE DEA/WINGOPHOTOGRAPHS ARE FOR EXPANSITIVE HYBERS FOR HOW THE CANAL RUDBEN CONDITIONS. THE SHORMAND IN FOR COORDINATION OF THE WORK TO BE PREFORMED BY THE CHEMBAL CONTRACTOR. THE AGENETIC FLARES NO EXPONENTIAL FOR THE ACCURACY OF THIS INPORTATION, THE GREEKAL CONTRACTOR SHALL EXAMINE THESE CONDITIONS HIT BY PRIOR TO EXISTING CONDITIONS. THE GENERAL CONTRACTOR SHALL VERY ALL CONDITIONS AND DIMENSIONS AND NOTIFY THE ARCHITECT OF ANY DISCREPANCES BETWEEN THE EXISTING CONDITIONS AND THE HEAVE AND CONTRACTOR SHALL WORK CONSTRUCTOR FOR THE ACCURACY OF THE ACCURACY OF THE PRIOR TO WORTH AND AND THE SHAPP OF THE PROPERTY OF THE PRIOR TO FOR THE PROPERTY OF THE PROPERTY OF THE PROPERTY OF THE PRIOR TO NOTIFICATION, THAT DOES NOT COMPONN TO THE PESSO OR LAYOUT OF THE PLANS AND DEBRINGHOUS SHALL ES REFLECTED BY THE GENERAL CONTRACTOR.
FOR COORDINATION OF THE WORK TO BE PREFORMED BY THE GENERAL CONTRACTOR. THE ARCHITECT BEARS NO RESPONSIBILITY FOR THE ACCURACY OF THIS INFORMATION. THE GENERAL CONTRACTOR SHALL EXAMINE THESE CONDITIONS IN THE FIELD PRIOR TO CONSTRUCTION AND BECOME FAMILIAR WITH THE WORK, AFTER EXAMINATION OF THE
EXISTING CONDITIONS, THE GENERAL CONTRACTOR SHALL VERIFY ALL CONDITIONS AND DIMENSIONS AND NOTEY THE ARCHITECT OF ANY DISCREPANCES BETWEEN THE EXISTING CONDITIONS AND THE NEW PROPOSED WORK. ALL WORK CONSTRUCTED PRIOR TO NOTIFICATION, THAT DOES NOT COMPORM TO THE DESIGN OR LAYOUT OF THE
PLANS AND DIMENSIONS SHALL BE REPLACED BY THE GENERAL CONTRACTOR.
ISSUES / REVISIONS
Date Description 11 JUL 22 AS-BUILT RELEASE
·
© FRANK SHIRLEY ARCHITECTS, 2022. All rights reserved.
© FRANK SHIRLEY ARCHITECTS, 2022. All rights reserved. This drawing cannot be reproduced without permission.
This drawing cannot be reproduced without permission.
DRAWING TITLE As-Built West Elevation
DRAWING TITLE As-Built West Elevation SCALE
DRAWING TITLE As-Built West Elevation SCALE
DRAWING TITLE As-Built West Elevation SCALE
DRAWING TITLE As-Built West Elevation SCALE 1 2 4 8 FT 1/4" = 1'-0" DATE
DRAWING TITLE As-Built West Elevation SCALE 1 2 4 8 FT 1/4" = 1'-0" DATE July 11, 2022
DRAWING TITLE As-Built West Elevation SCALE 1 2 4 8 FT 1/4" = 1'-0" DATE



AS BUILT NORTH ELEVATION

SCALE: 1/4" = 1'-0"

ARCHITECTS

40 Pearl Street t: 617.547.3355 Cambridge MA 02139 f: 617.547.2385

www.frankshirleyarchitects.com

PROJECT

Alterations to:

The MAGDANZ RESIDENCE

172 Brattle St. Cambridge, MA 02138

THISSE EXISTING CASA ADDOR PHOTOGRAPHS ARE A REPRESENTATION OF THE
EXISTING CONTROL OF THE BUSINESS AND A REPRESENTATION OF THE
THE GENERAL CREAKCHESING OF THE EXISTING CONDITIONS AND BOT AN
THE GENERAL CREAKCHESING OF THE EXISTING CONDITIONS AND BOT AND
THOS CONDITIONS THOUGH OF THE THE WAY TO BE REPORTED BY THE GENERAL CONTROL
THE ARCHITECT BEAS NO BESPONSIBILITY FOR THE ACCURACY OF THIS BROTHANTON
THE GENERAL CONTROL CONTROL CANADA WITH THE WORK, AFTER EXMANDATION OF THE OPENION OF THE CONTROL CONTRO

ISSUES / REVISIONS

Date	Description	
11 JUL 22	AS-BUILT RELE	

© FRANK SHIRLEY ARCHITECTS, 2022. All rights reserved.
This drawing cannot be reproduced without permission.

DRAWING TITLE

As-Built North Elevation

0 1 2	8 FT	1/4" = 1'-0'
DATE		

July 11, 2022

SHEET NUMBER

AB-2.01







VIEW FROM CORNER OF BRATTLE & CHANNING





FRANK SHIRLEY ARCHITECTS

www.frankshirleyarchitects.com

Addition & Alterations to:

The MAGDANZ RESIDENCE

172 Brattle St. Cambridge, MA 02138

Cambridge MA 02139

t: 617.547.3355 f: 617.547.2385

NOT FOR CONSTRUCTION

© FRANK SHIRLEY ARCHITECTS, 2022. All rights reserved. This drawing cannot be reproduced without permission.

DRAWING TITLE

ISSUES / REVISIONS

13 SEP 22 CHC SUBMISSION

Existing Photos

N.T.S.

September 13, 2022

SHEET NUMBER

P-1