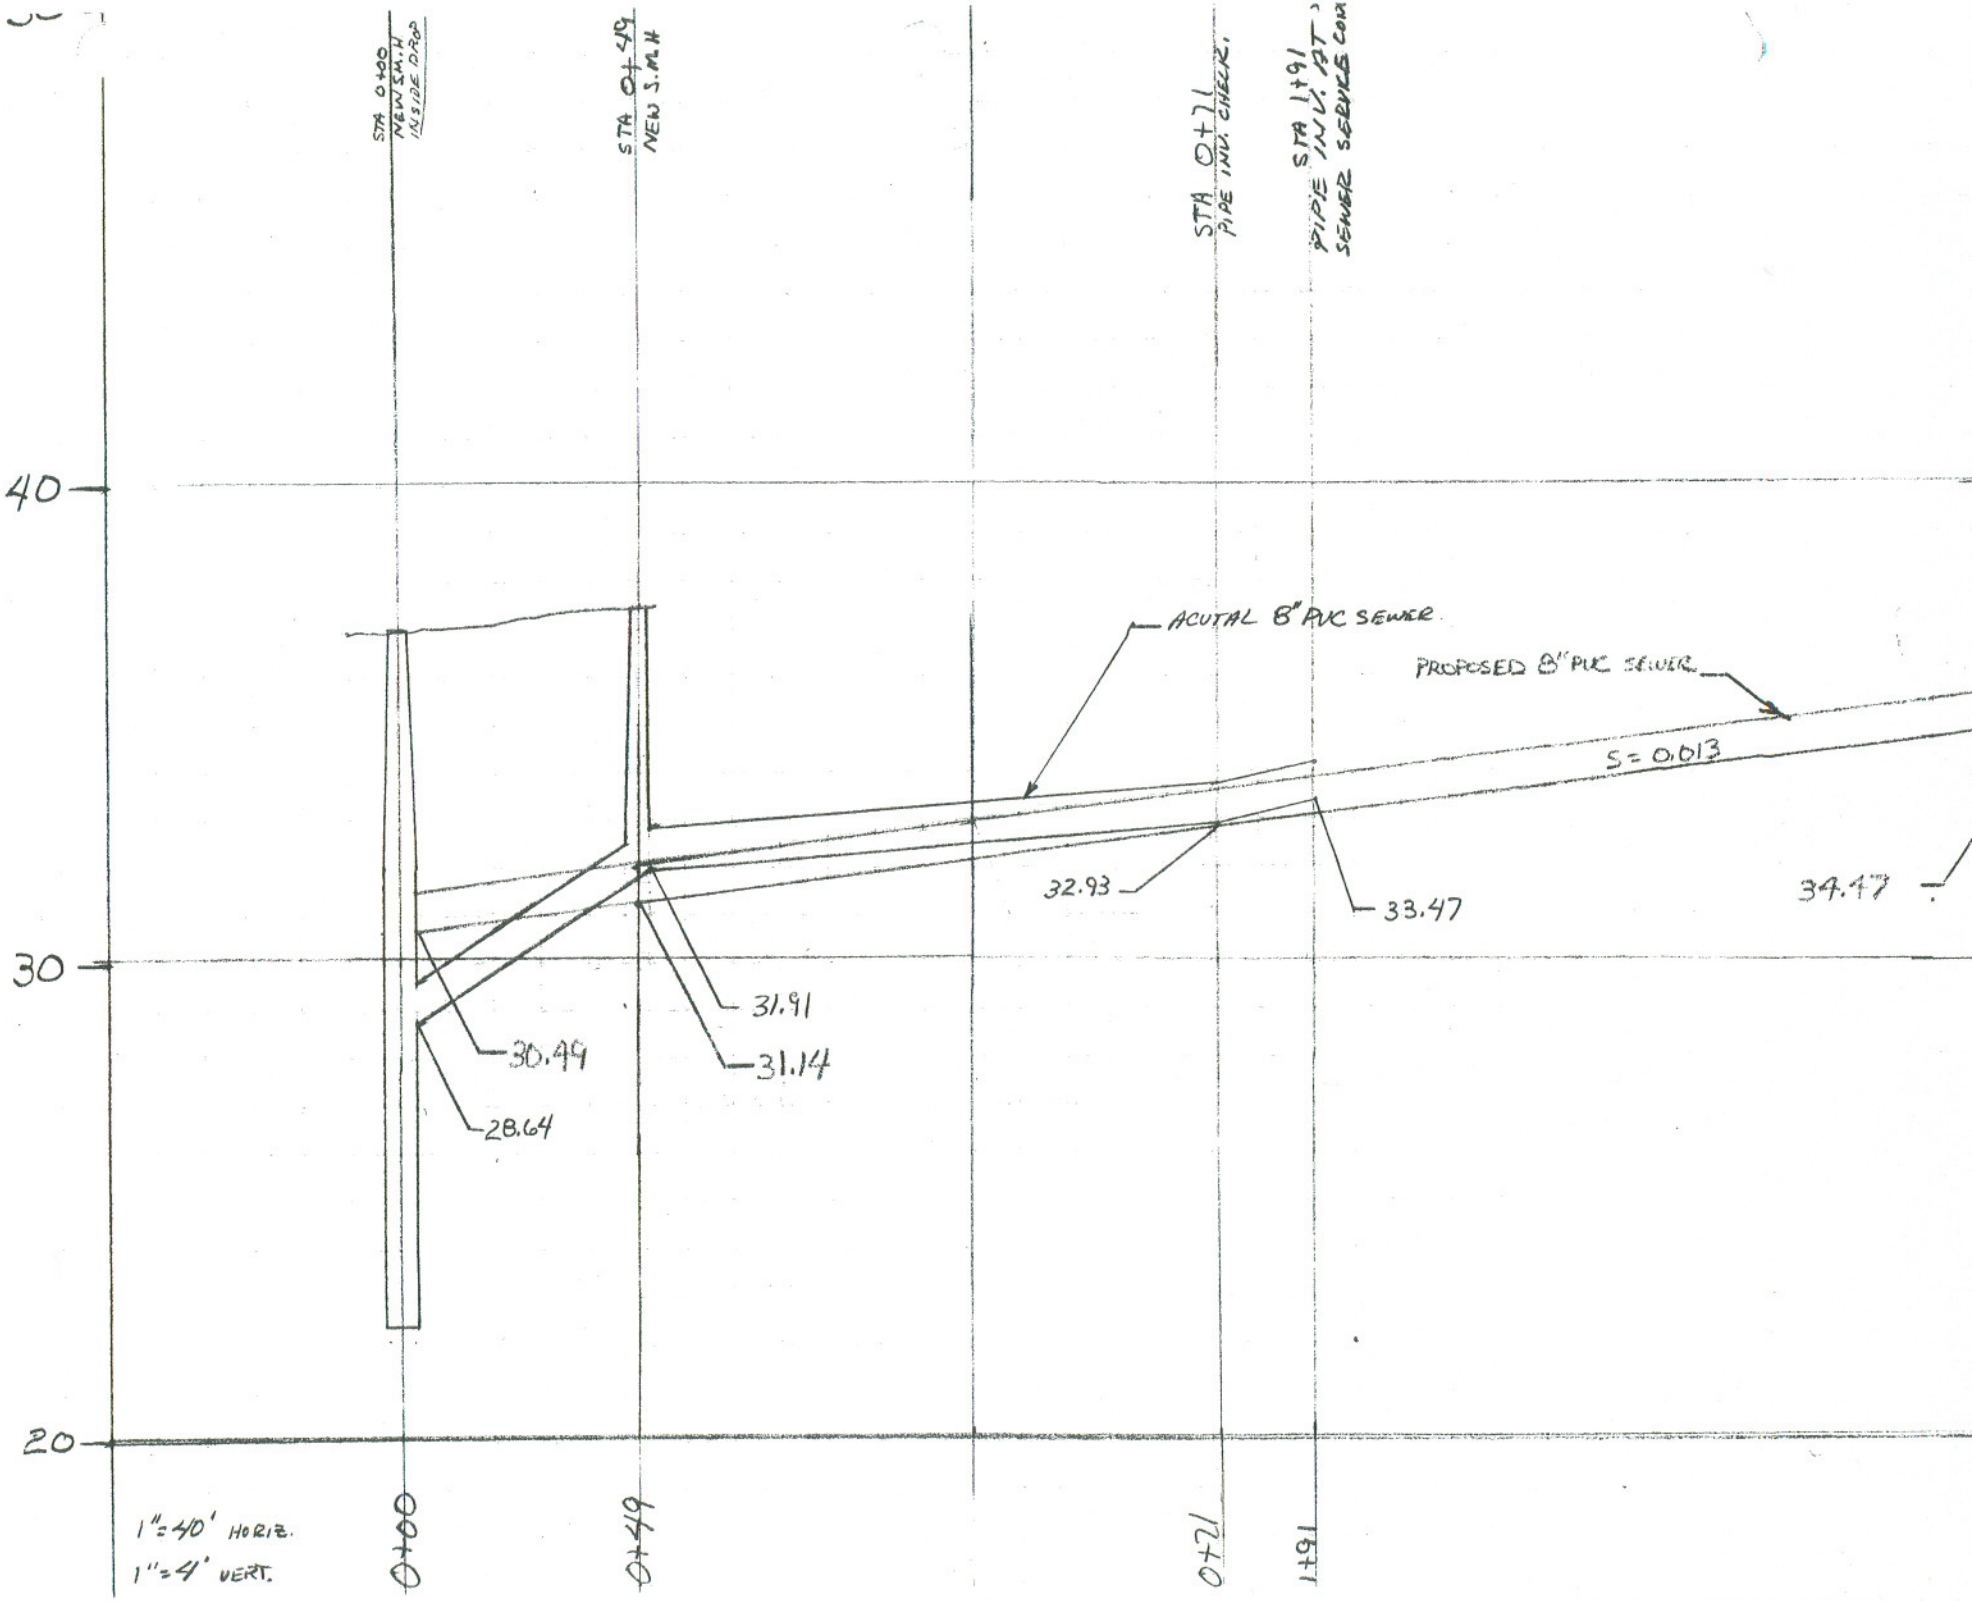
STA 0+00
NEW S.M.H
INSIDE DROP
STA 0+49
NEW S.M.H
STA 0+71
PIPE INV. CHELR.
STA 1+91
PIPE INV. AT
SEWER SERVICE CON
40
30
20
ACUTAL 8" PVC SEWER
PROPOSED 8" PVC SEWER
S = 0.013
32.93
33.47
34.47
31.91
31.14
30.49
28.64
1" = 40' HORIZ.
1" = 4' VERT.
0+00
0+49
0+71
1+91

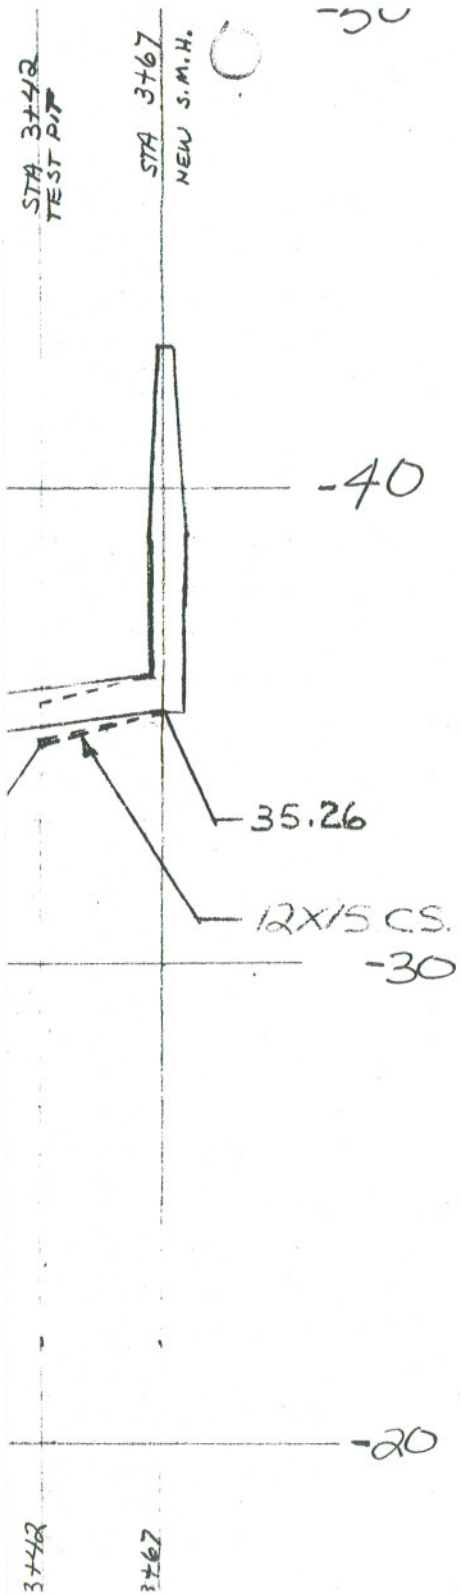

RED = PER DRAWING 11 DATED 8-30-89
PENCIL = AS BUILT
GREEN = 12X15 CS.

3/22/97
LM II

WARE ST